



\\ad.rkk.com\is\Cloud\Projects\2022\22132_JMUFFGROV\CADD\Source Drawings\Grading (Concept)-R.dwg / 11/22/2022 6:29:52 PM by -----

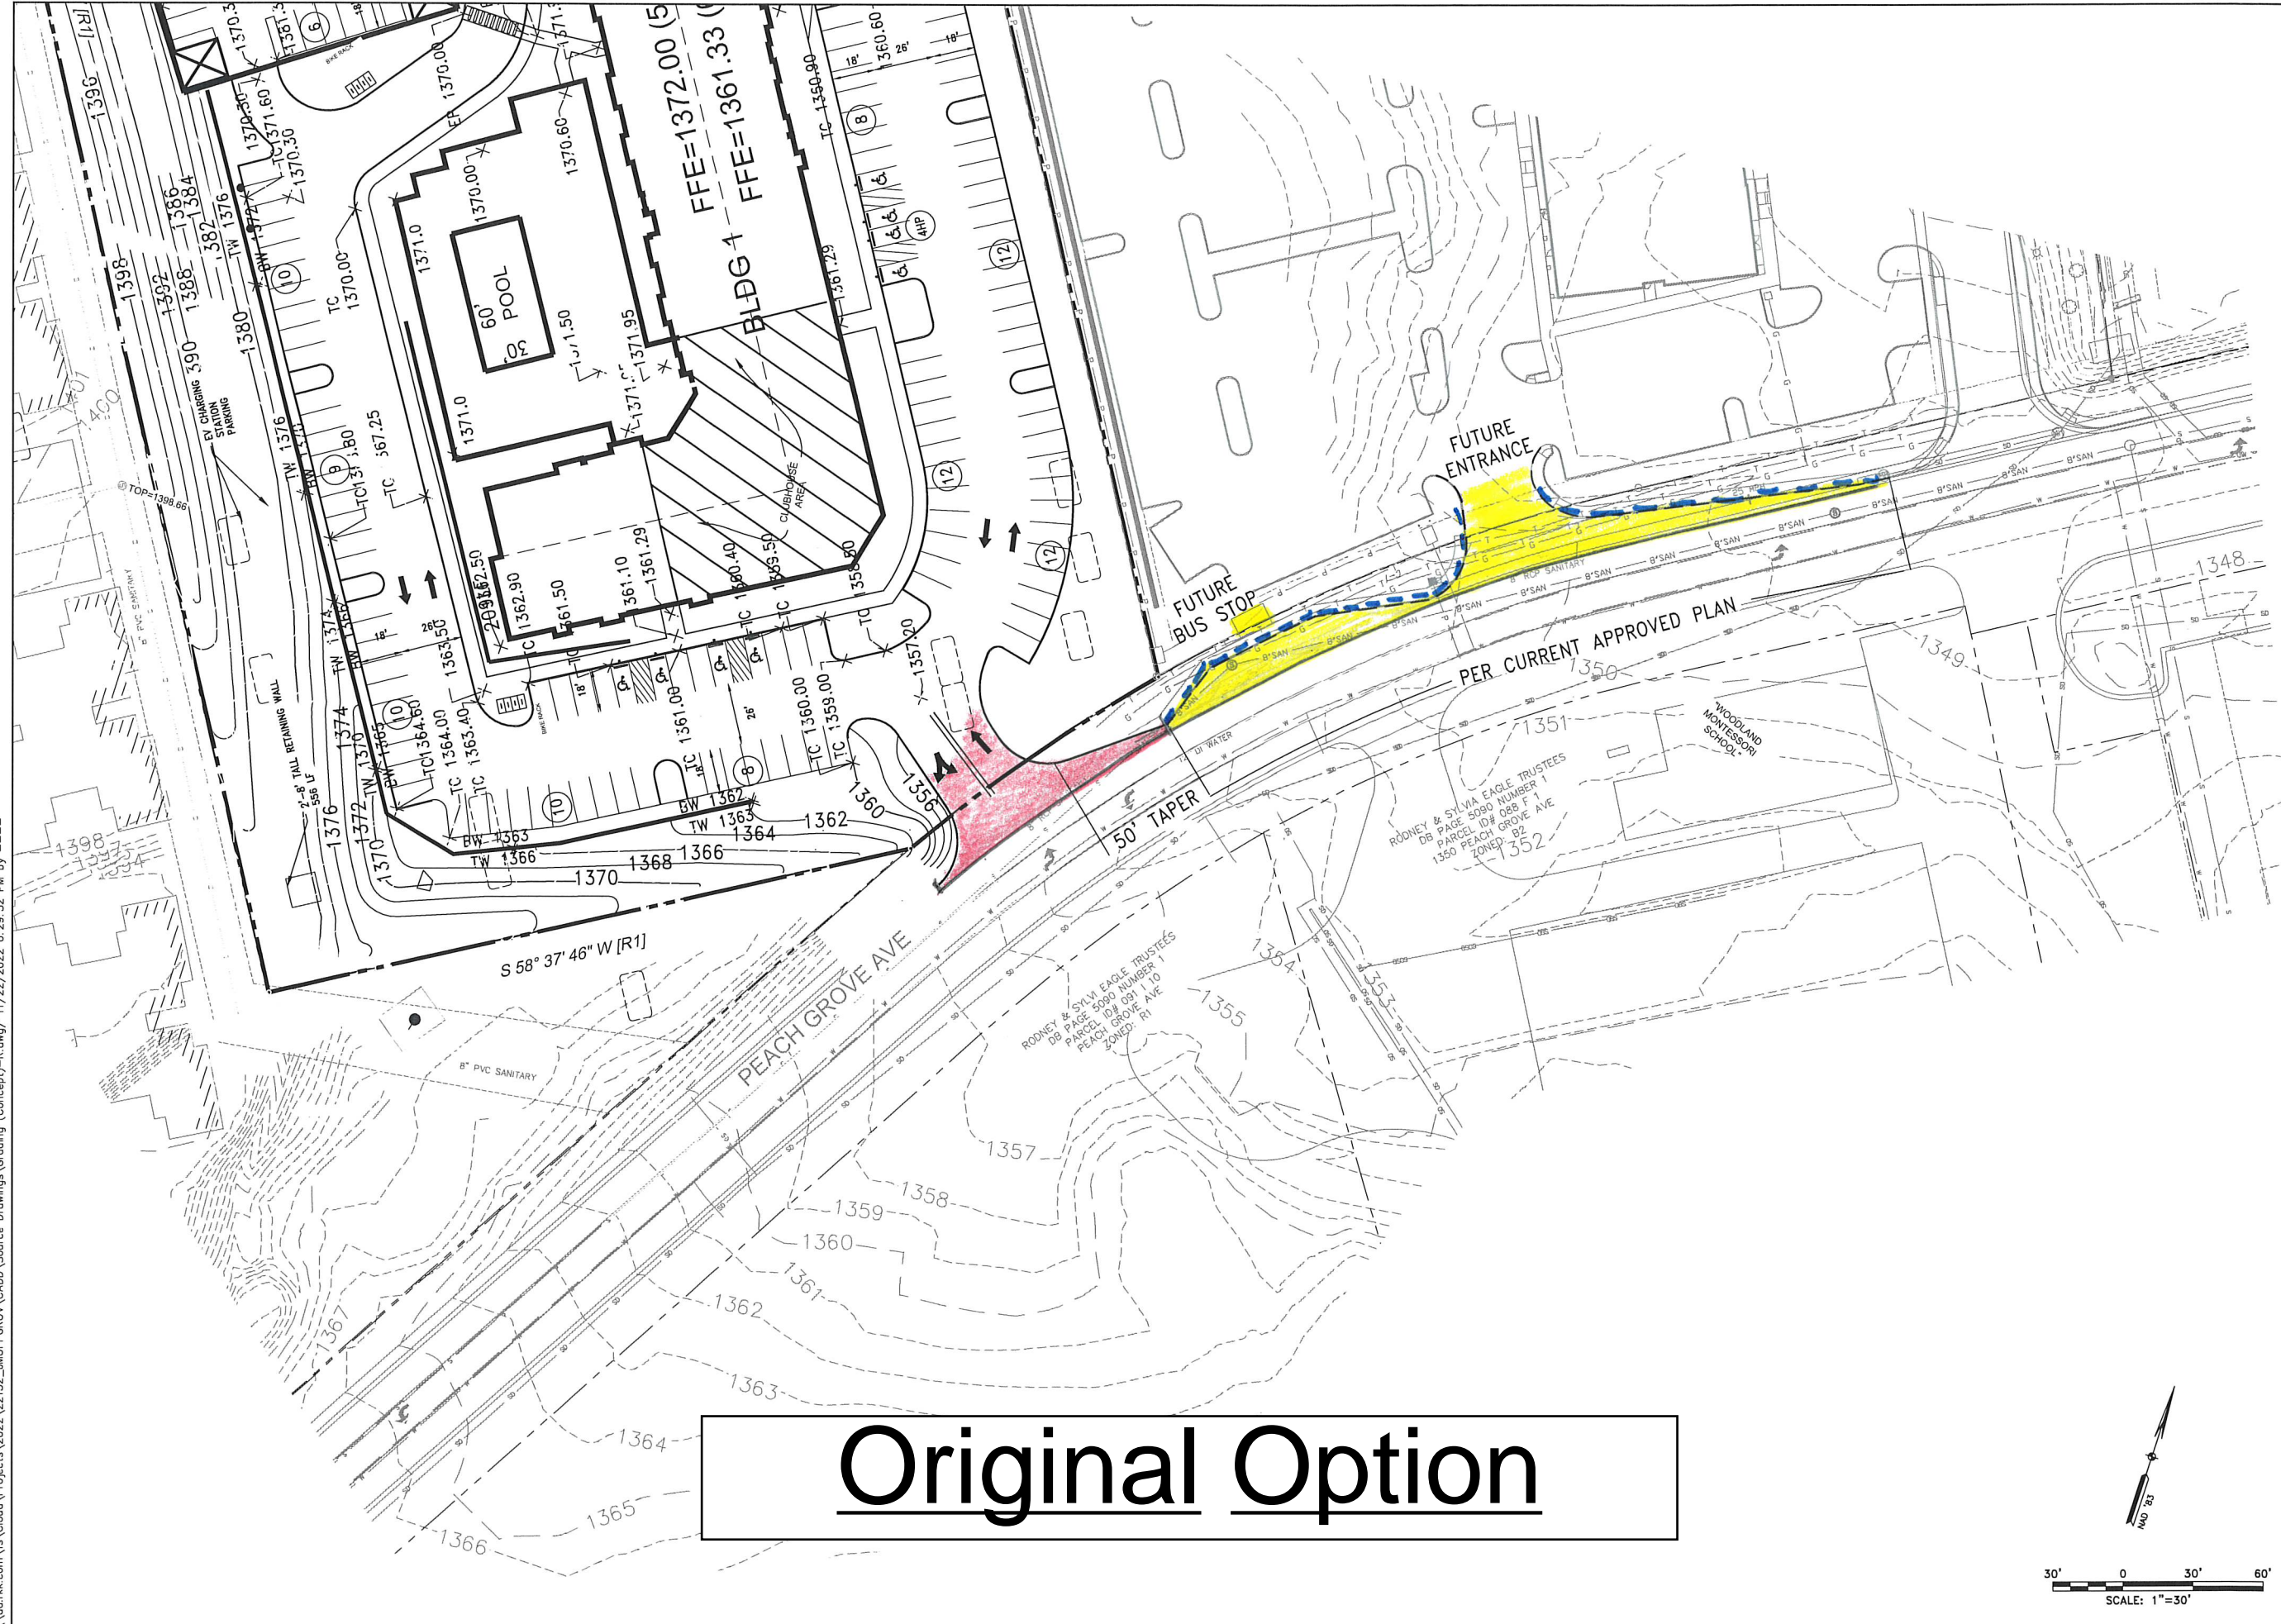

Original Option

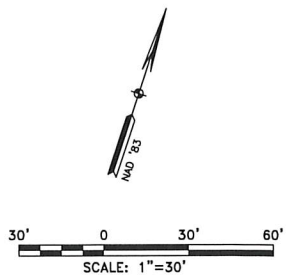


<p>DATE: 11/21/2022 ENGINEER: MMM CHECKED: MMM CAD: MCH, OJG JOB#: 22132</p>	<p>LINGERFELT DEVELOPMENT APARTMENTS CITY OF HARRISONBURG, VIRGINIA</p>	<p>PLAN REVISIONS -</p> <table border="1" style="width: 100%; border-collapse: collapse;"> <tr> <td style="width: 50%;">SHEET</td> <td>C1.0</td> </tr> <tr> <td>SCALE</td> <td>1"=30'</td> </tr> </table>	SHEET	C1.0	SCALE	1"=30'	<p>CURRENT PLAN ENTRANCE</p>
SHEET	C1.0						
SCALE	1"=30'						

\\ad.rkk.com\fs\Cloud\Projects\2022\22132_MUFFGROVE\CADD\Source Drawings\Grading (Concept)-R.dwg / 11/23/2022 10:50:27 AM by -----




Alternate Option A

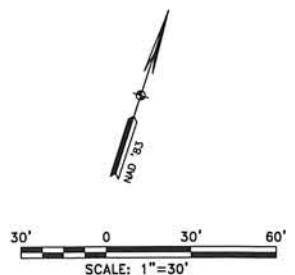


DATE: 11/21/2022 ENGINEER: MMM CHECKED: MMM CAD: MCH, OJG JOB #: 22132	LINGERFELT DEVELOPMENT APARTMENTS CITY OF HARRISONBURG, VIRGINIA		SHEET C1.0	PLAN REVISIONS -
	OPTION A ENTRANCE		SCALE 1"=30'	


RKK
 P: 804.762.1903 Suite 309 | Richmond, VA 23223
 Engineers | Construction Managers | Planners | Scientists
 www.rkk.com
 Responsive People | Creative Solutions

\\od.rkk.com\fs\Cloud\Projects\2022\22132_JM\FGRDVA\CADD\Source Drawings\Grading (Concept)-R.dwg / 11/23/2022 10:46:32 AM by -----

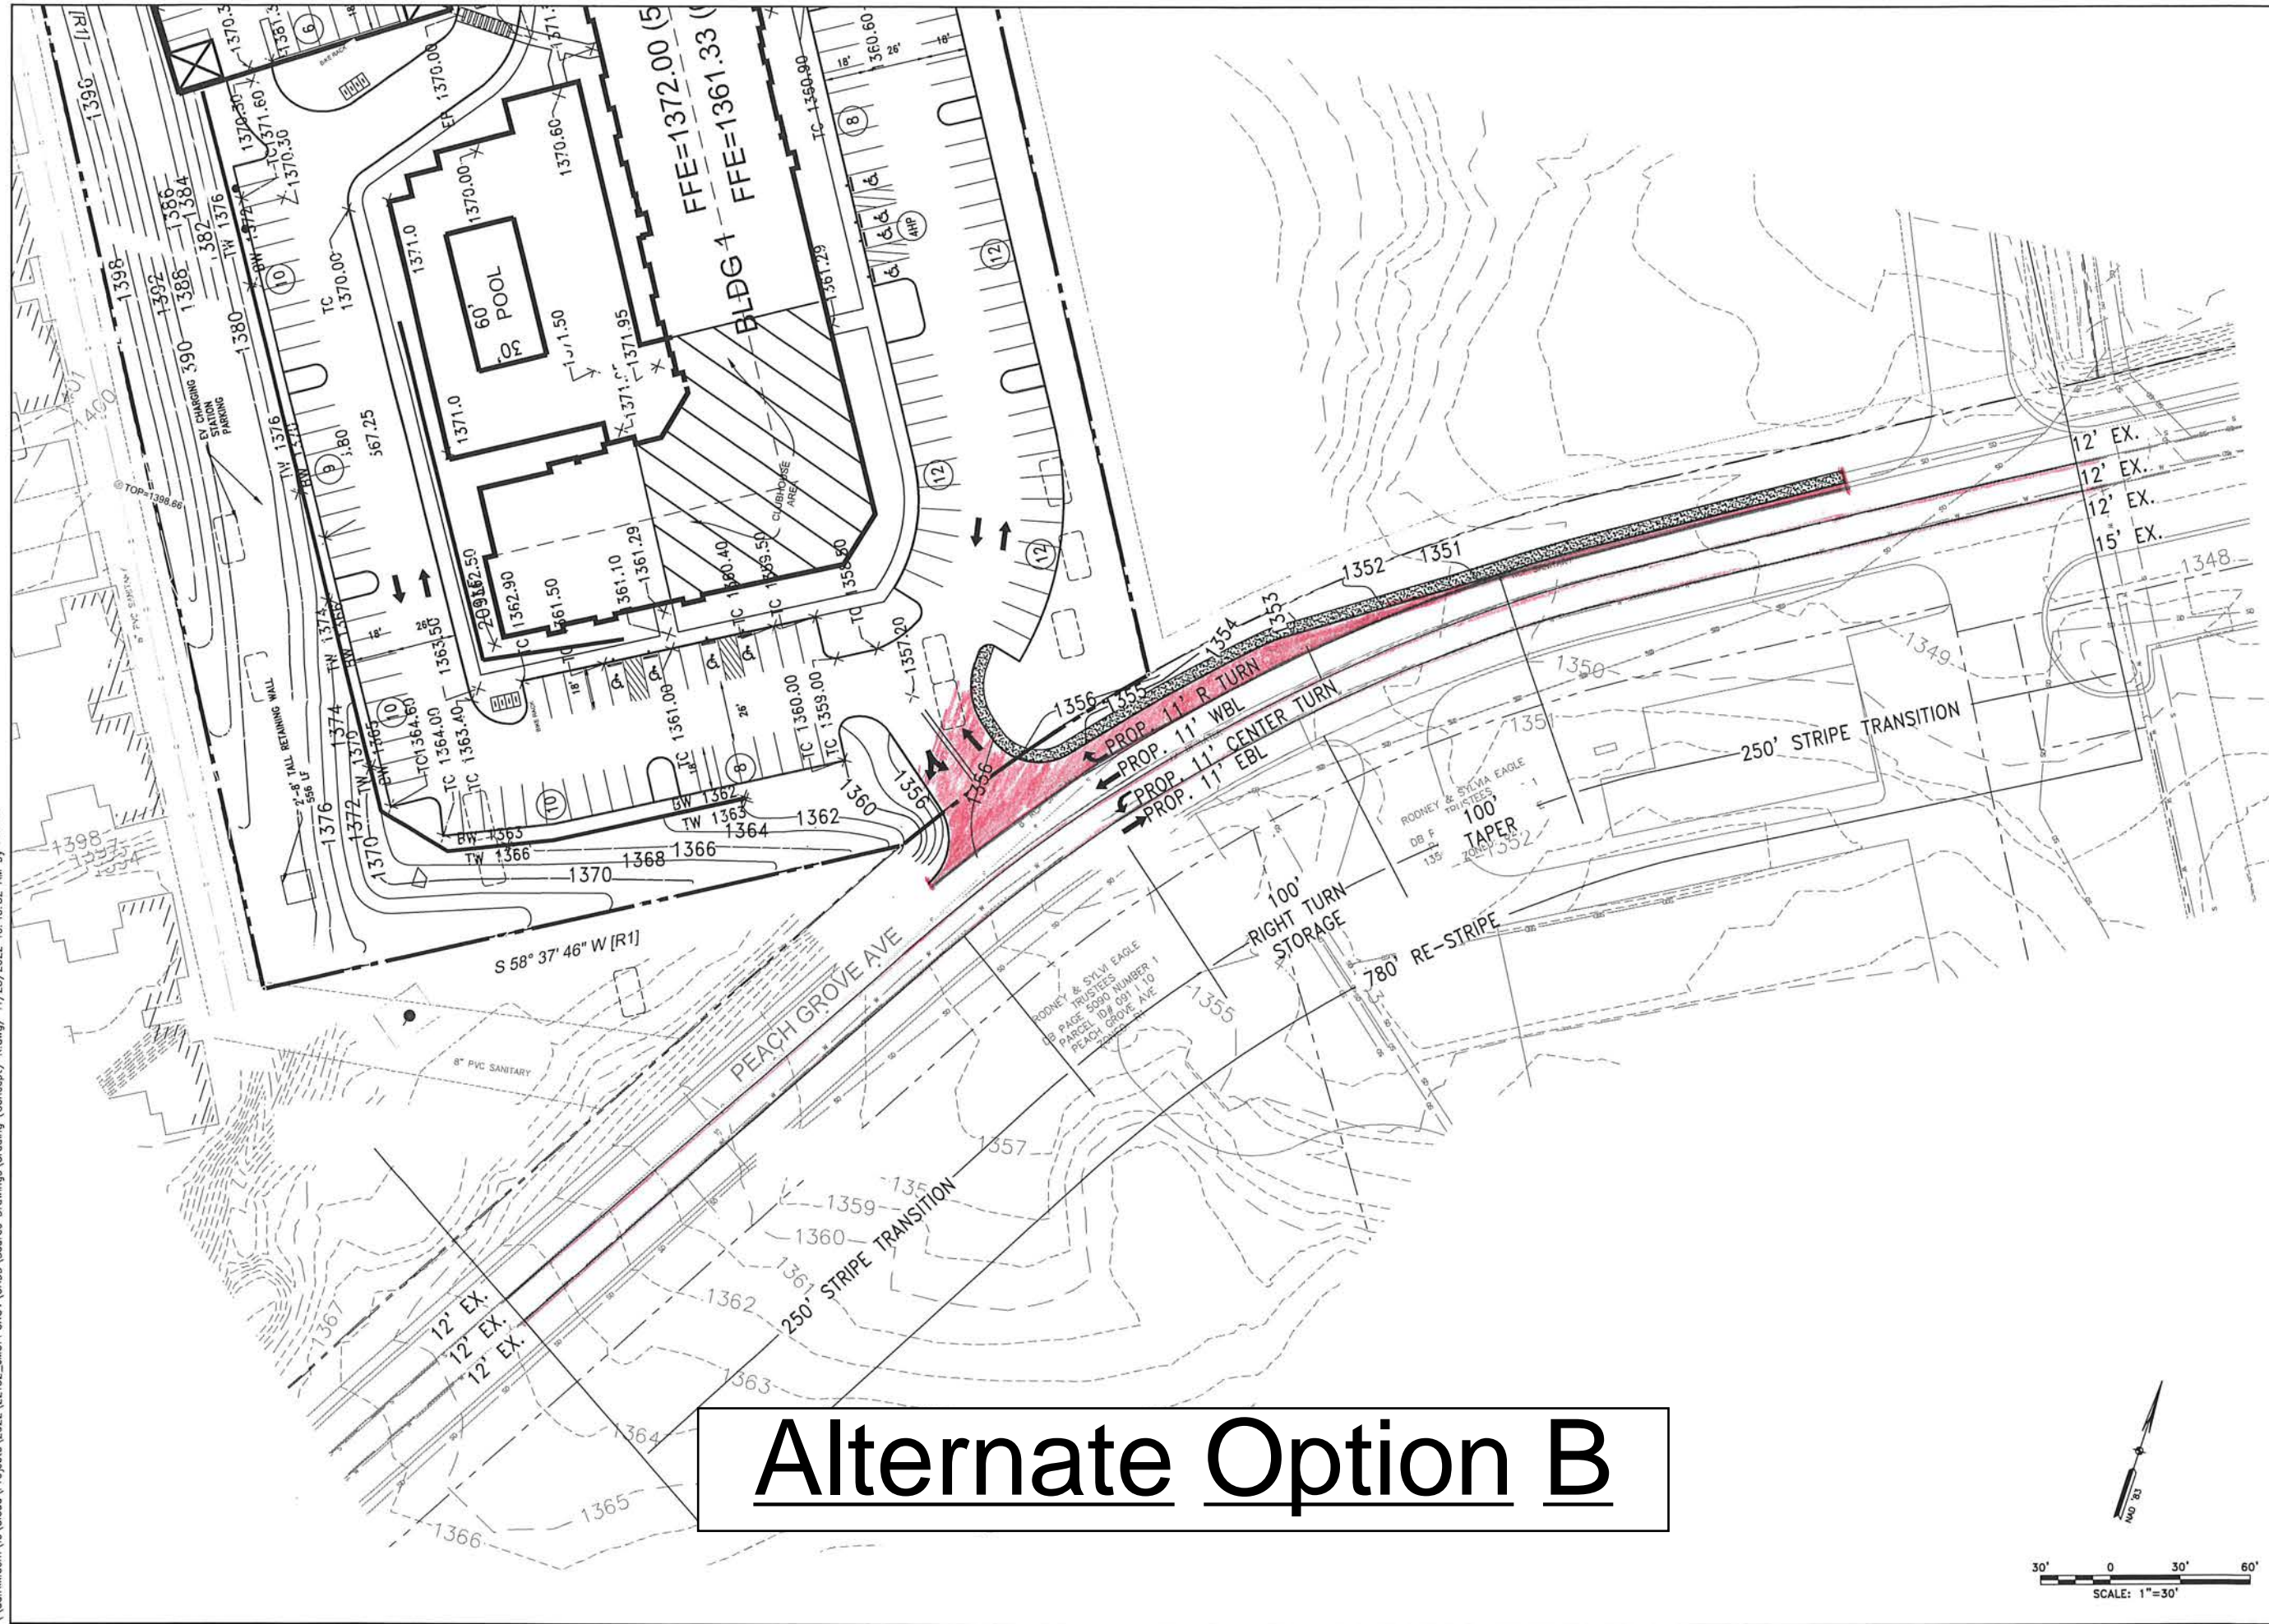


Alternate Option B

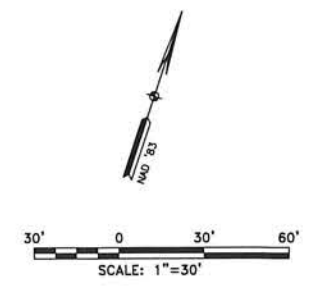


LINGERFELT DEVELOPMENT APARTMENTS CITY OF HARRISONBURG, VIRGINIA	SHEET	C.1.0	PLAN REVISIONS -
	SCALE	1"=30'	
DATE: 11/21/2022 ENGINEER: MMM CHECKED: MMM CAD: MCH, OJG JOB#: 22132			
OPTION B ENTRANCE			

\\od.rkk.com\is\Cloud\Projects\2022\22132_JMUFPROV\CADD\Source Drawings\Grading (Concept)-R.dwg/ 11/23/2022 10:43:13 AM by -----

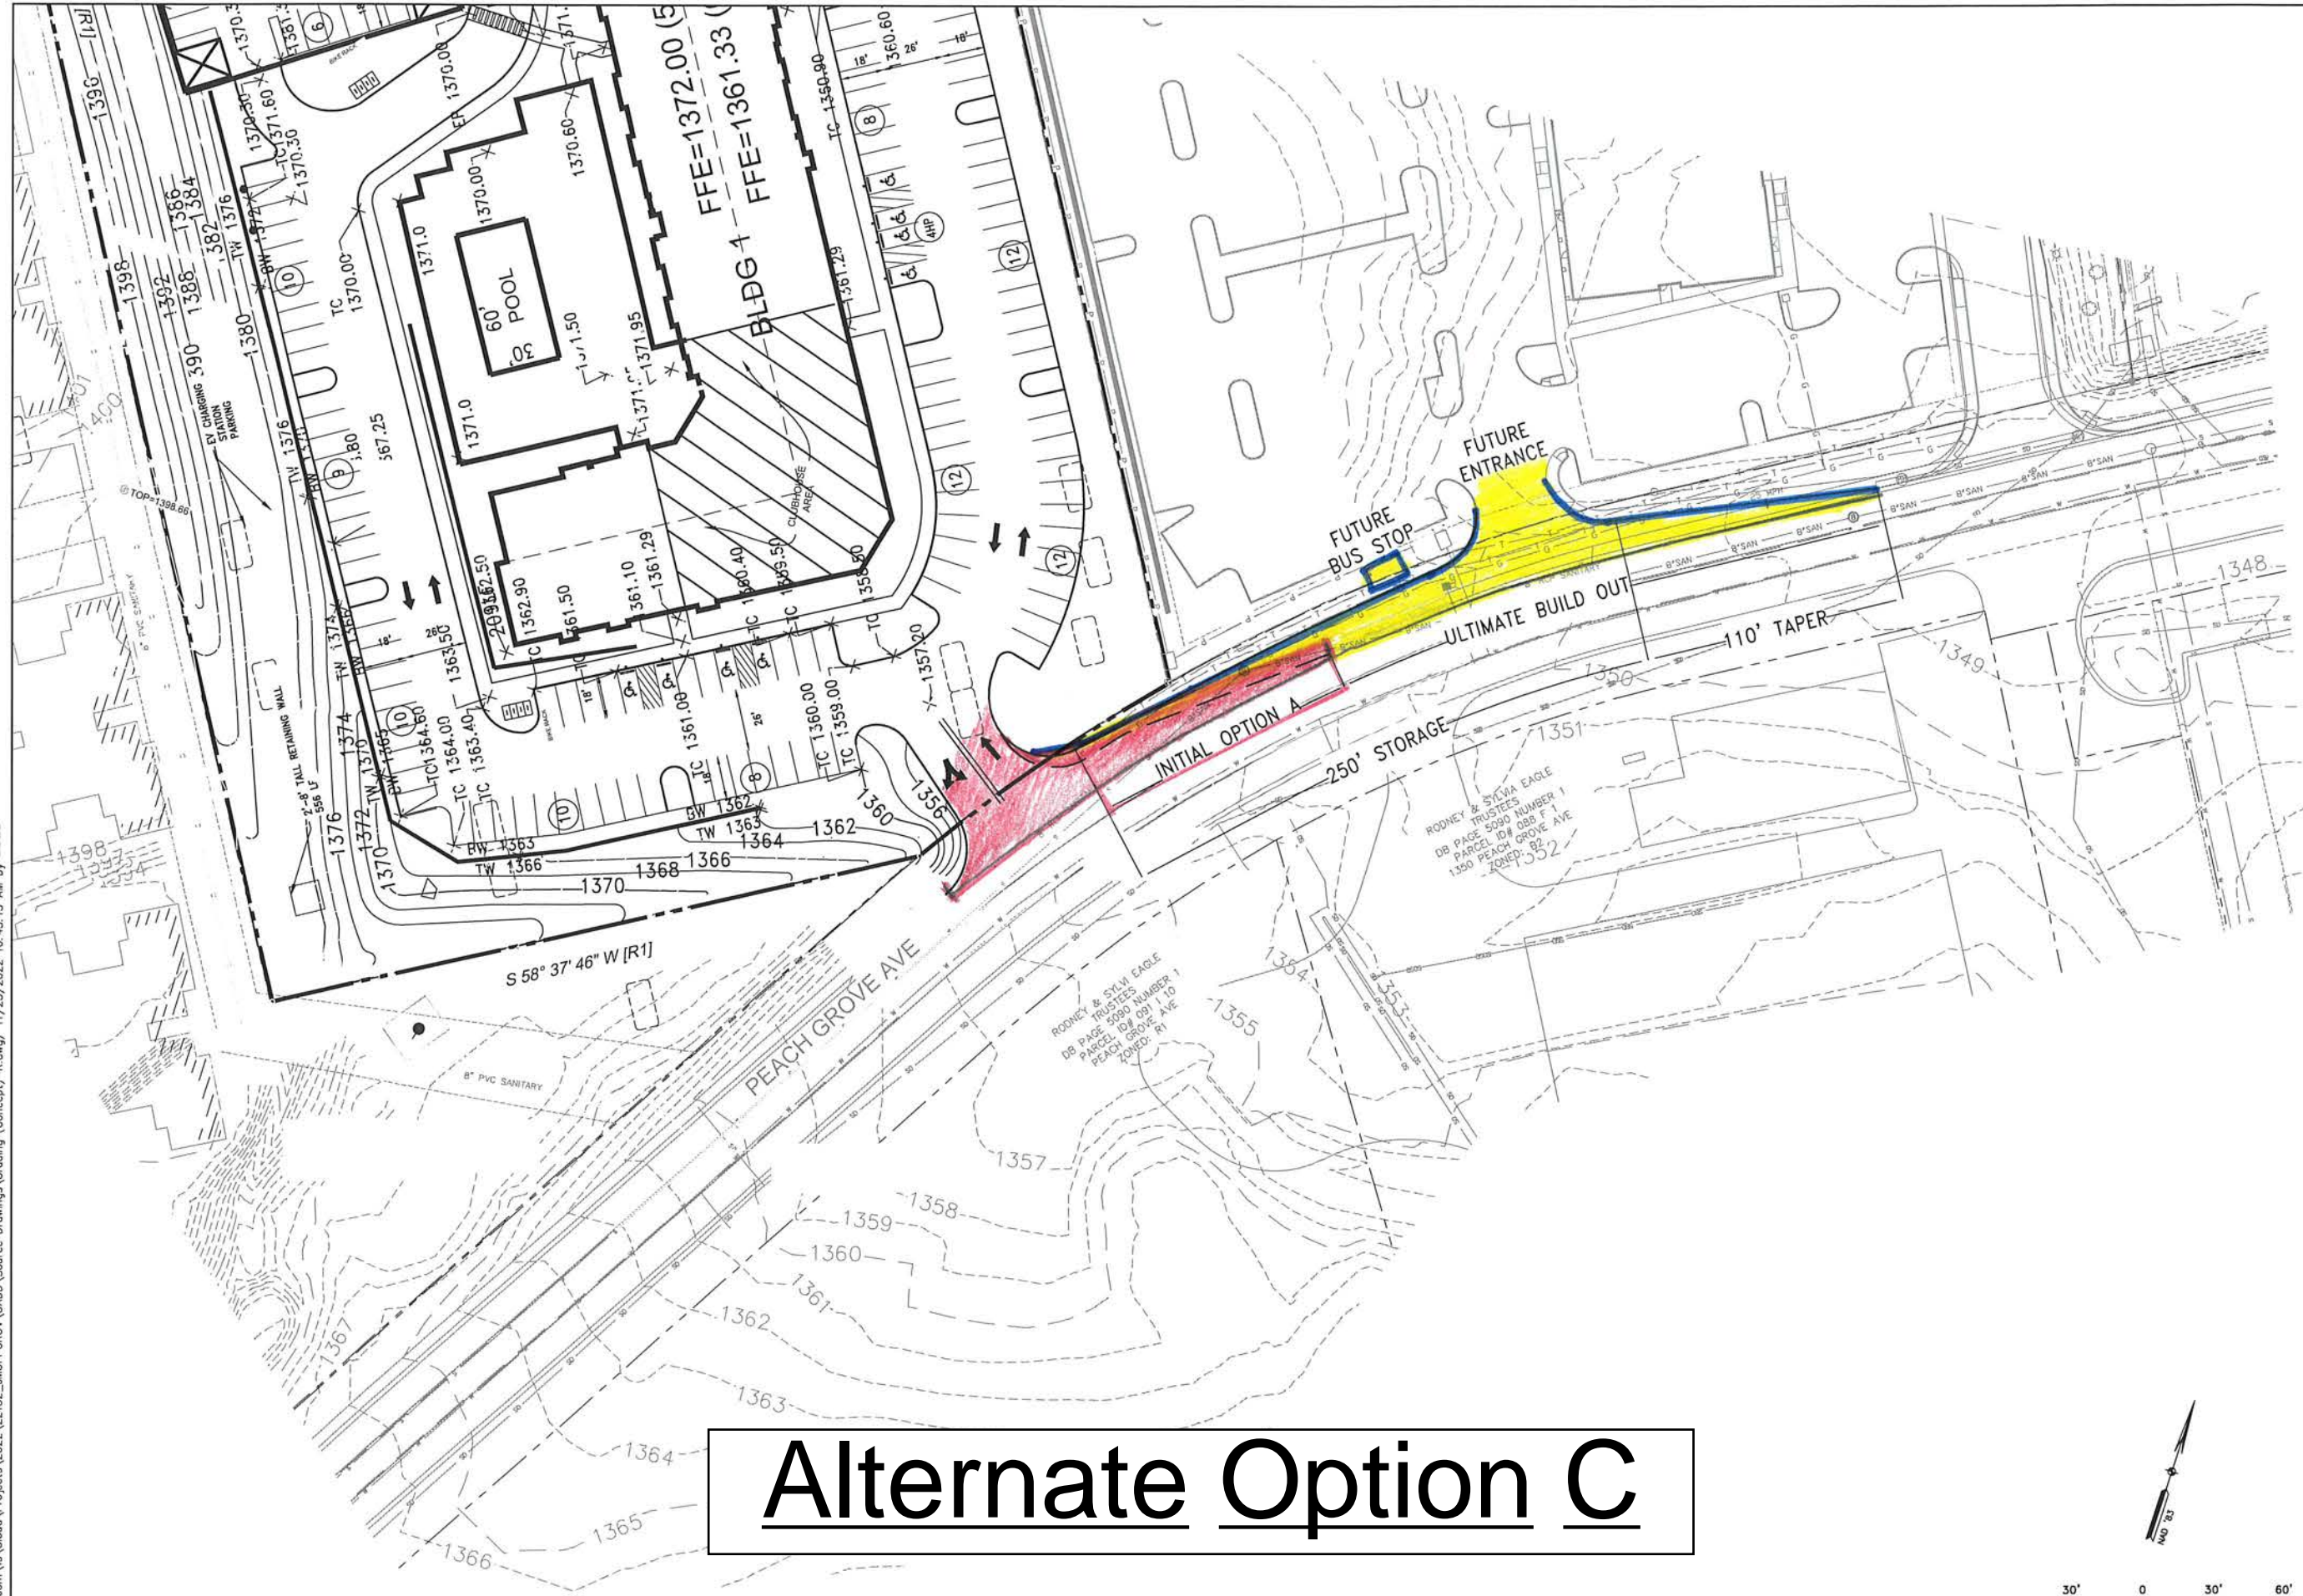


Alternate Option C

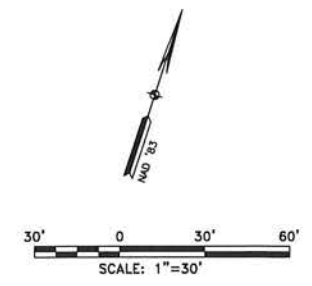

DATE: 11/21/2022 ENGINEER: MMM CHECKED: MMM CAD: MCH, OJG JOB#: 22132	LINGERFELT DEVELOPMENT APARTMENTS CITY OF HARRISONBURG, VIRGINIA		PLAN REVISIONS -
	SHEET C.1.0	SCALE 1"=30'	ULTIMATE BUILD OUT OPTION
 RKK 2100 E. Cary St., Suite 309 Richmond, VA 23223 Engineers Construction Managers Planners Scientists www.rkk.com Responsive People Creative Solutions			

\\cad.rk.com\fs\Cloud\Projects\2022\22132_MUFFPROV\CADD\Source Drawings\Grading (Concept)-R.dwg / 12/1/2022 1:35:08 PM by -----

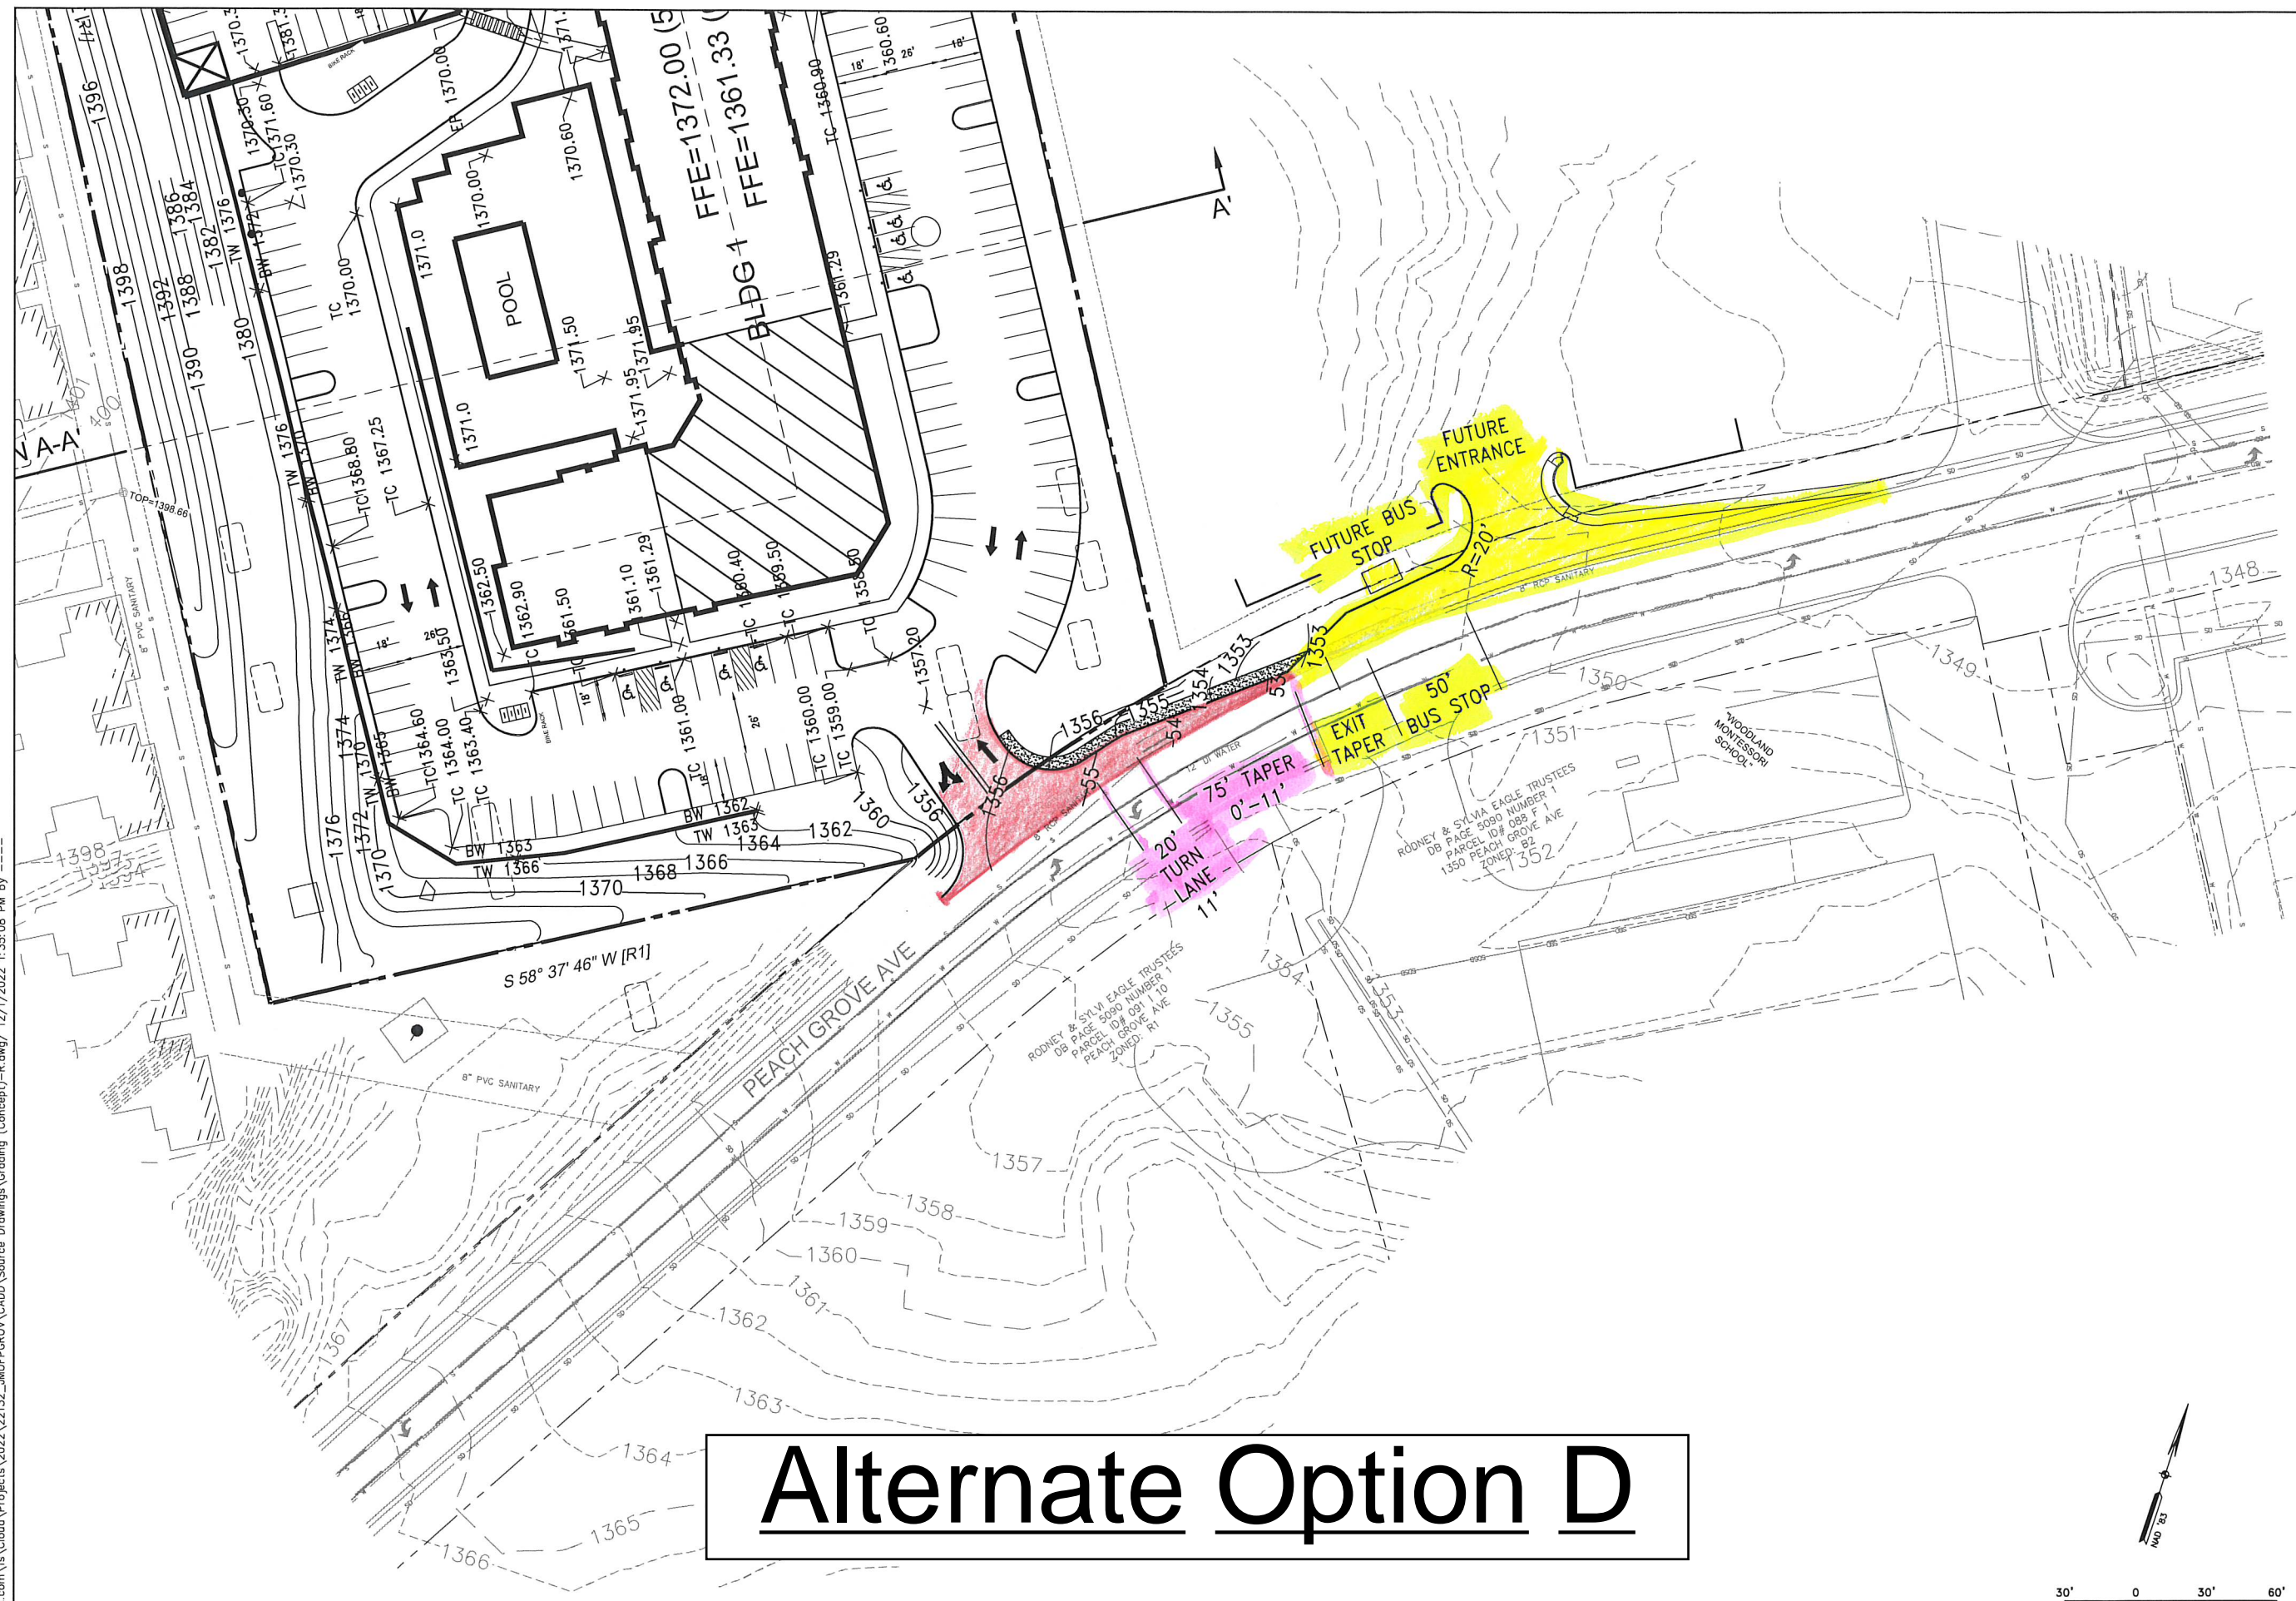


Alternate Option D


DATE: 11/21/2022 ENGINEER: MMM CHECKED: MMM CAD: MCH, OJG JOB#: 22132	LINGERFELT DEVELOPMENT APARTMENTS CITY OF HARRISONBURG, VIRGINIA		PLAN REVISIONS - SHEET C1.0 SCALE 1"=30'
	OPTION "A" WITH FUTURE ENTRY & BUS STOP		

RK&K
 P. 864, 782, 783
 2100 E. Cary St., Suite 300 | Richmond, VA 23223
 Engineers | Construction Managers | Planners | Scientists
 www.rk.com
 Responsive People | Creative Solutions

\\ad.rkk.com\FS\Cloud\Projects\2022\22132_MUFFGROVE\CADD\Source Drawings\Grading (Concept)-R_OPTION D.dwg / 12/13/2022 2:29:07 PM by -----

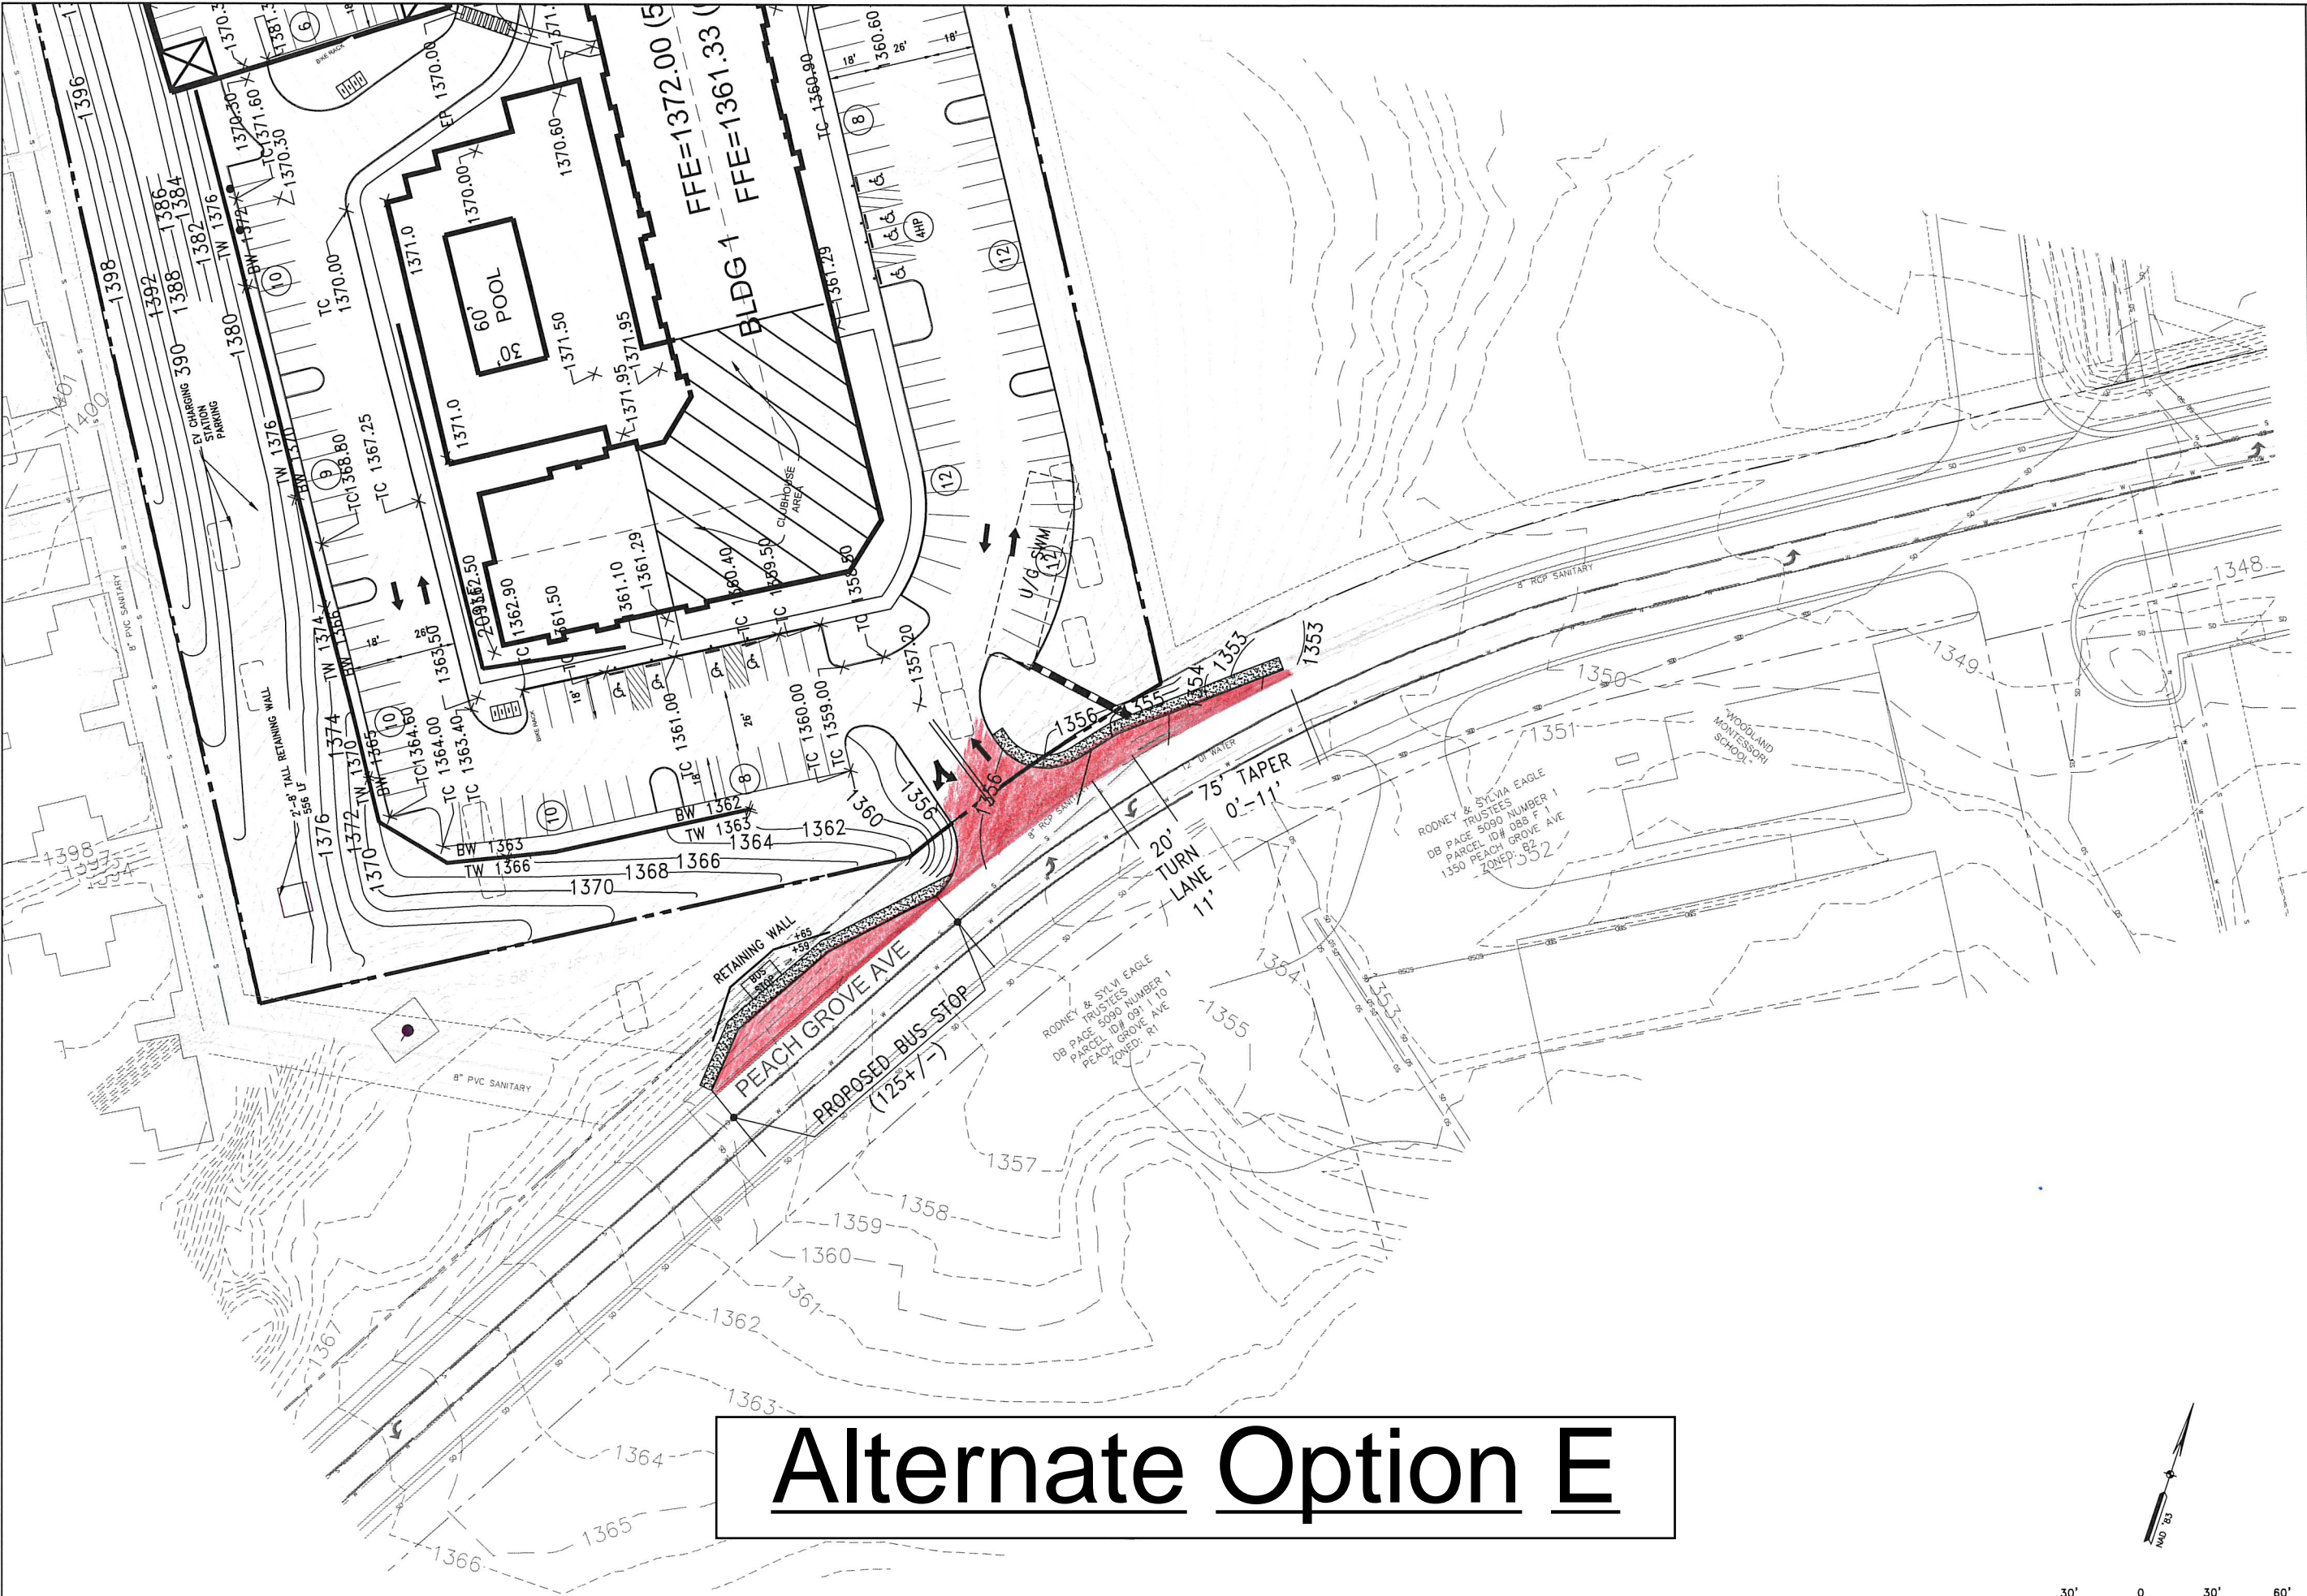

Alternate Option E

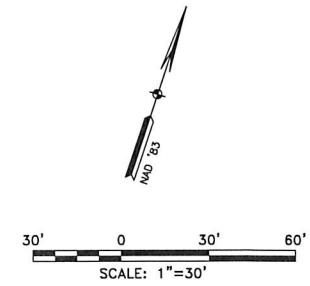

DATE: 11/21/2022 ENGINEER: MMM CHECKED: MMM CAD: MCH, OJG JOB#: 22132	LINGERFELT DEVELOPMENT APARTMENTS CITY OF HARRISONBURG, VIRGINIA OPTION "E" ENTRANCE WITH BUS STOP WEST		PLAN REVISIONS - 1) 12/22/22 REVISED PER CITY REVIEW COMMENTS 11/29/22 2) 12/28/22 REVISED PER CITY COMMENTS 12/18/22
	DATE: 11/21/2022 ENGINEER: MMM CHECKED: MMM CAD: MCH, OJG JOB#: 22132	DATE: 11/21/2022 ENGINEER: MMM CHECKED: MMM CAD: MCH, OJG JOB#: 22132	DATE: 11/21/2022 ENGINEER: MMM CHECKED: MMM CAD: MCH, OJG JOB#: 22132

RK&K
 P: 804.782.1903
 2100 E. Cary St. Suite 309 | Richmond, VA 23223
 Engineers | Construction Managers | Planners | Scientists
 www.rkk.com
 Responsive People | Creative Solutions